


PLANNING DRAWING




PROPOSED FRONT ELEVATION 1:100

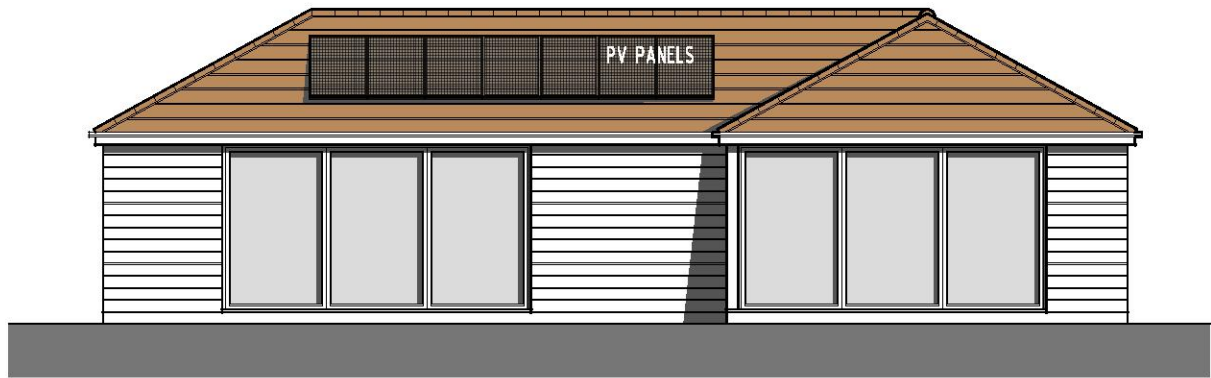

PROPOSED SIDE ELEVATION 1:100



PROPOSED REAR ELEVATION 1:100

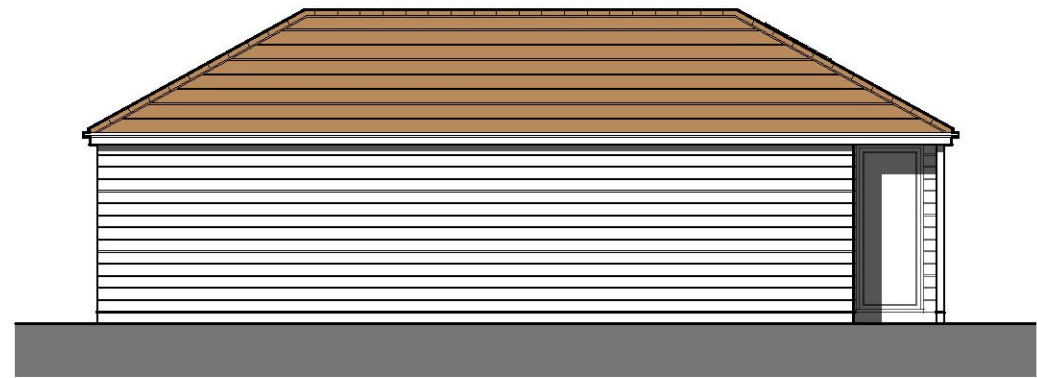

PROPOSED SIDE ELEVATION 1:100

© Copyright for all rights reserved. All rights reserved. Architectural.
This drawing is a copyright of BDA. No part of this drawing may be reproduced without the written permission of BDA.
Important Note: This drawing is for information only. It is not to be used for construction purposes without the written permission of BDA.
Do not scale from this drawing. Use figured dimensions only. (all levels & dimensions to be checked on site).




PROPOSED SECTION THROUGH 1:100

Revised scheme forming this application to be set in from the boundary wall a minimum of 400mm (up to 700mm) opposed to the approved scheme.

To be finished with horizontal cladding.

Allow to remove existing outbuilding as shown as dashed red lines for clarity.

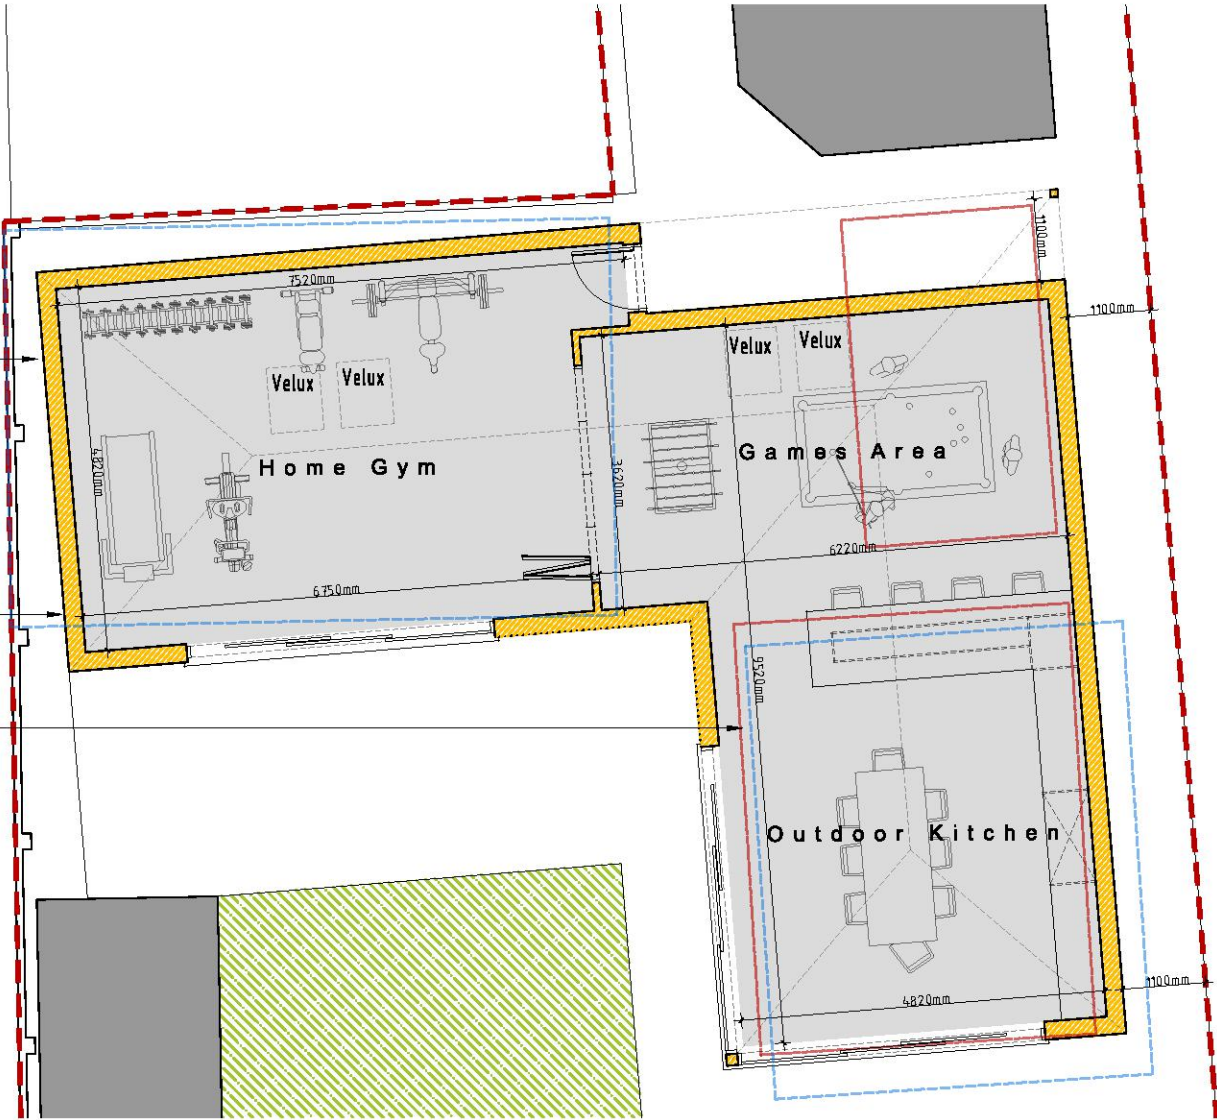

PROPOSED FLOOR PLAN 1:100



Client:
Chris Rider
Location:
Elmlake House,
Rochford, SS4 1NT.
Project:
Proposed Single Storey Outbuilding.
(AS APPROVED Plans + Elevations)
Drawn: cp
Scale: 1:100
Drawing No: 21.169/03
Checked: cp
Date: July 2023
Rev: C

